


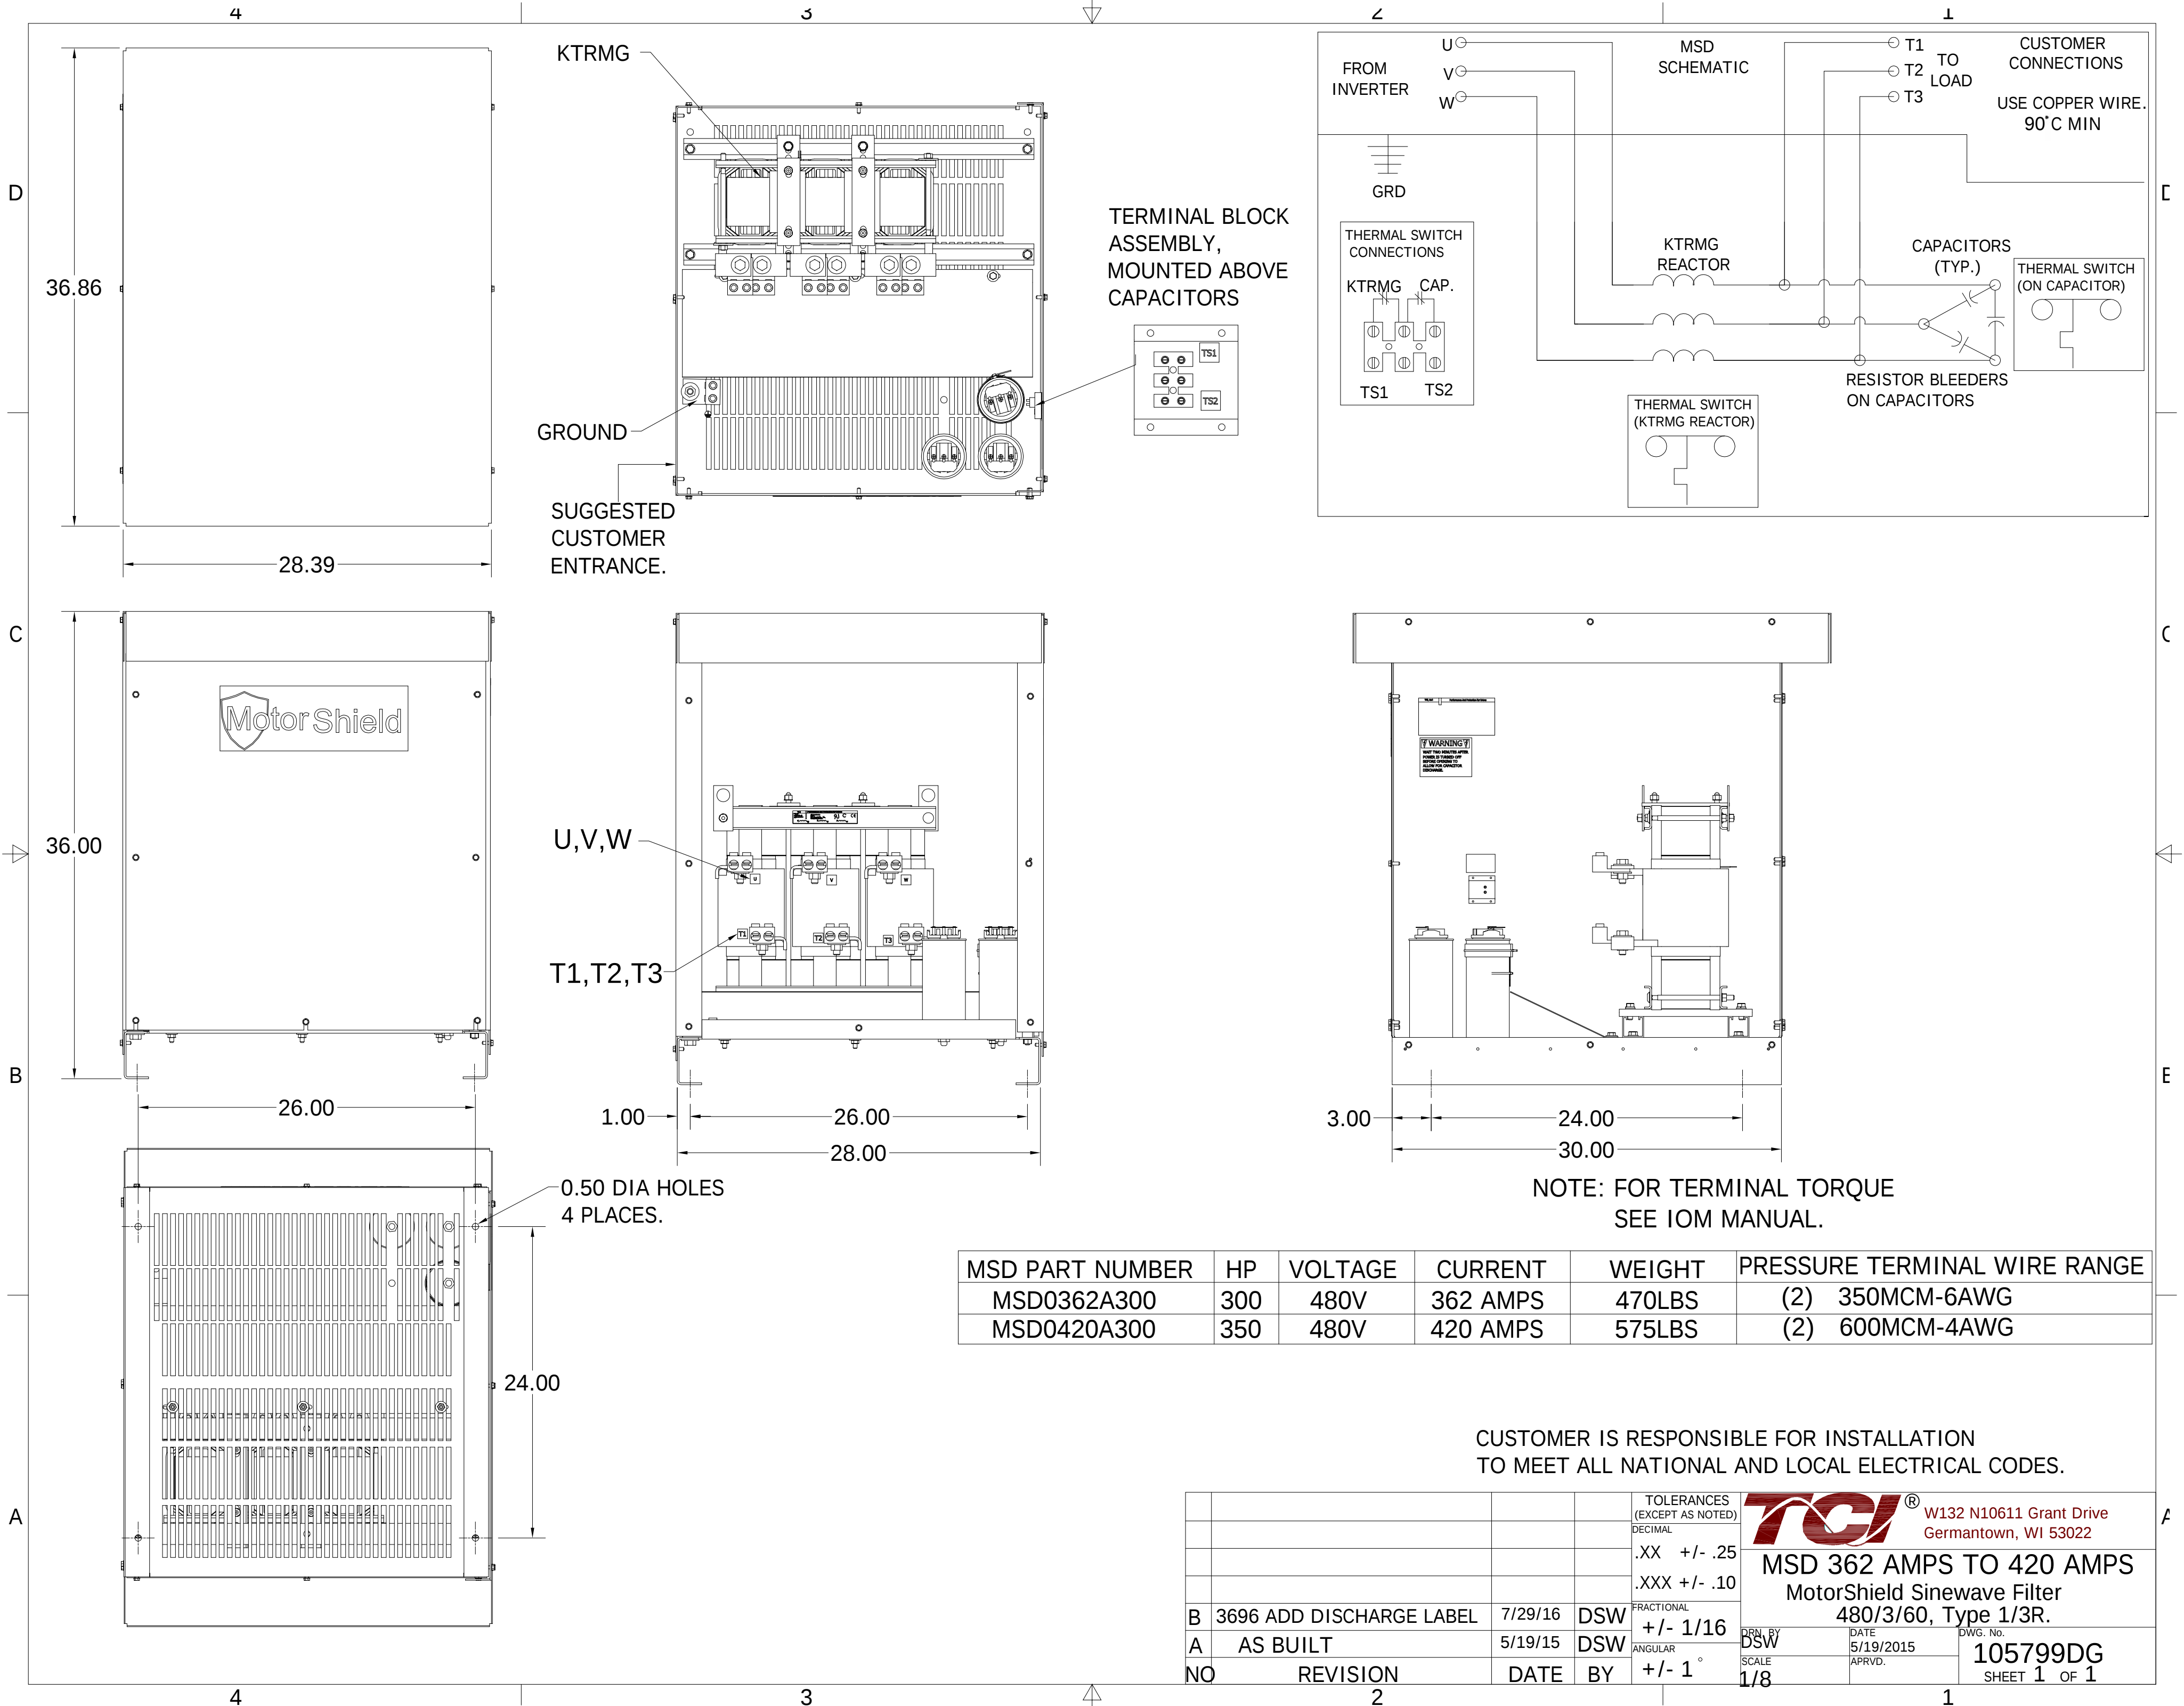

MSD PART NUMBER	HP	VOLTAGE	CURRENT	WEIGHT	PRESSURE TERMINAL WIRE RANGE
MSD0362A300	300	480V	362 AMPS	470LBS	(2) 350MCM-6AWG
MSD0420A300	350	480V	420 AMPS	575LBS	(2) 600MCM-4AWG

				TOLERANCES (EXCEPT AS NOTED)	 W132 N10611 Grant Drive Germantown, WI 53022 MSD 362 AMPS TO 420 AMPS MotorShield Sinewave Filter 480/3/60, Type 1/3R.		
				DECIMAL			
				.XX +/- .25			
				.XXX +/- .10			
B	3696 ADD DISCHARGE LABEL	7/29/16	DSW	FRACTIONAL	DRN. BY DSW		
A	AS BUILT	5/19/15	DSW	ANGULAR			
NO	REVISION	DATE	BY	+/- 1°	SCALE	DATE 5/19/2015	DWG. No. 105799DG
					1/8	APRVD.	SHEET 1 OF 1