

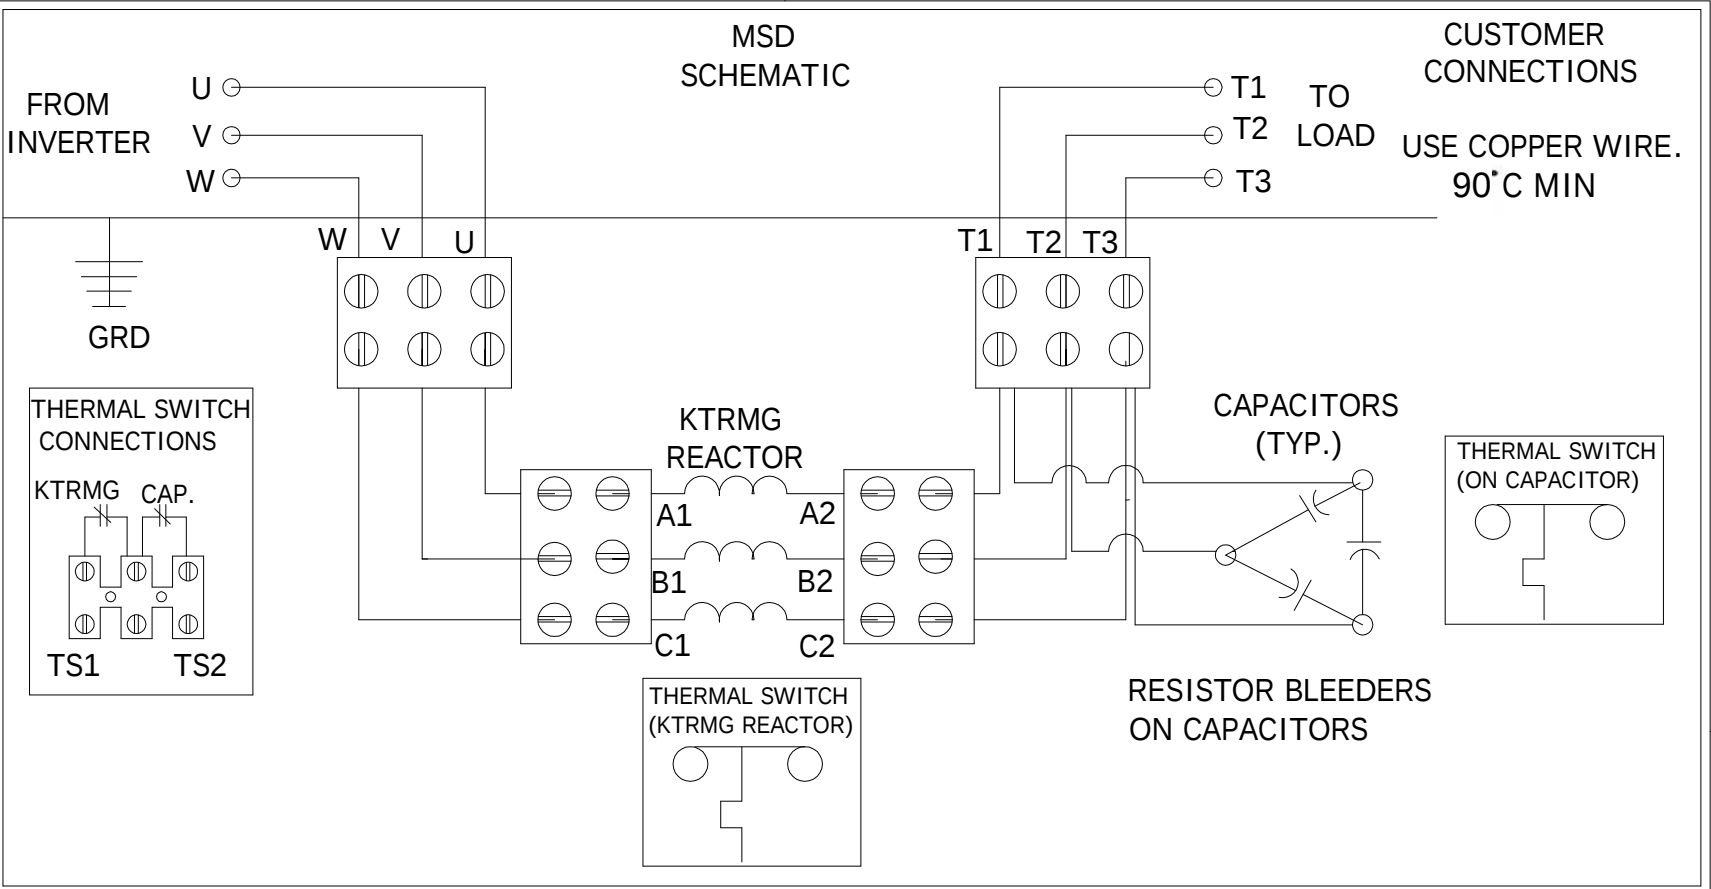
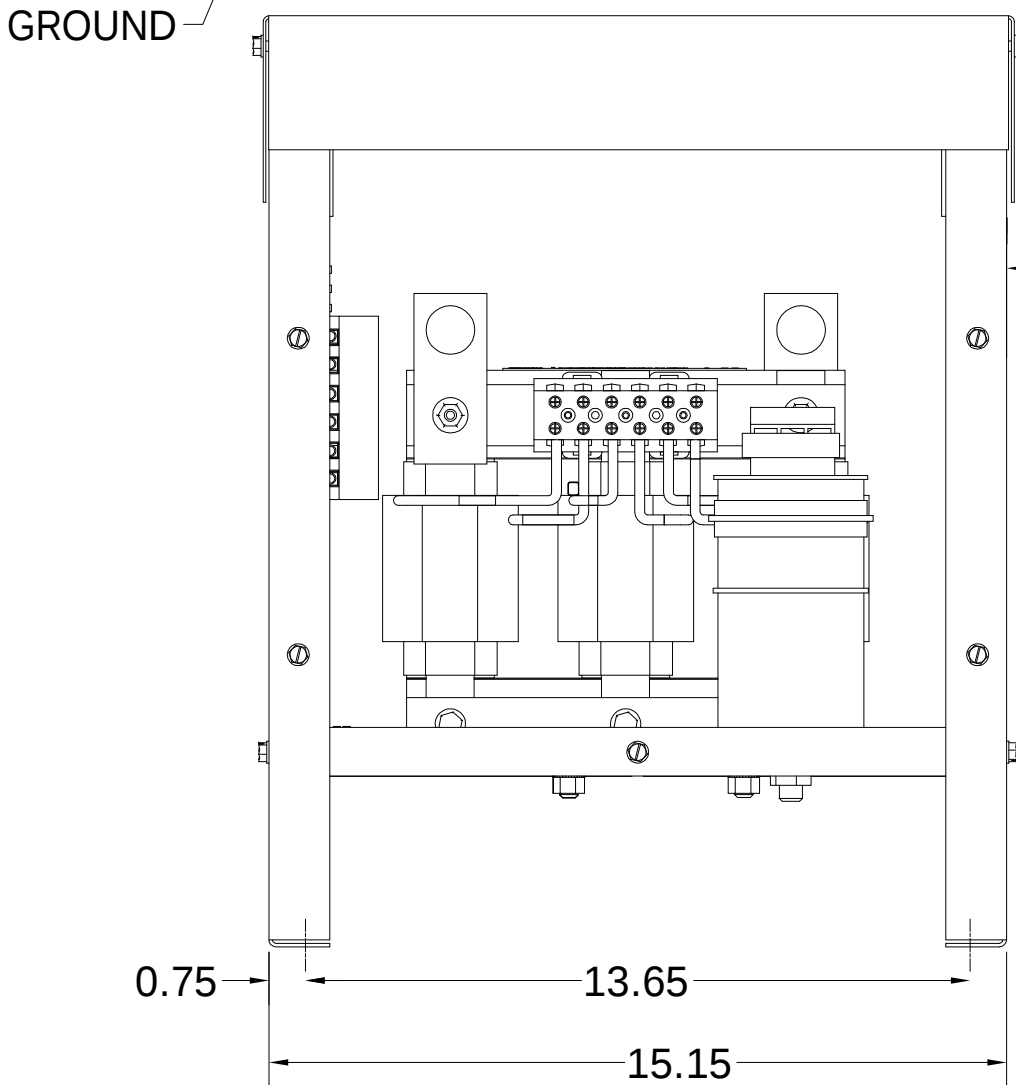
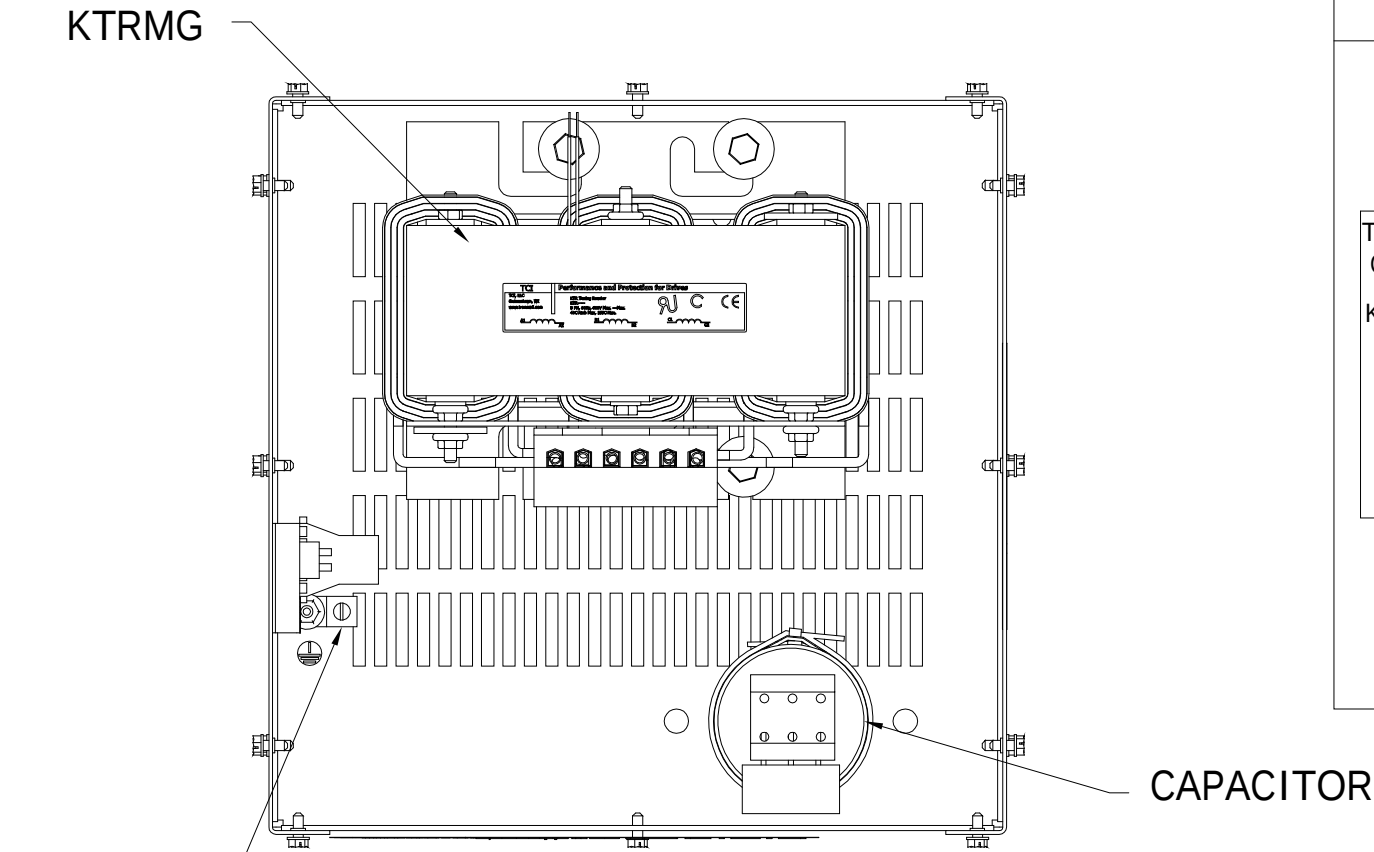
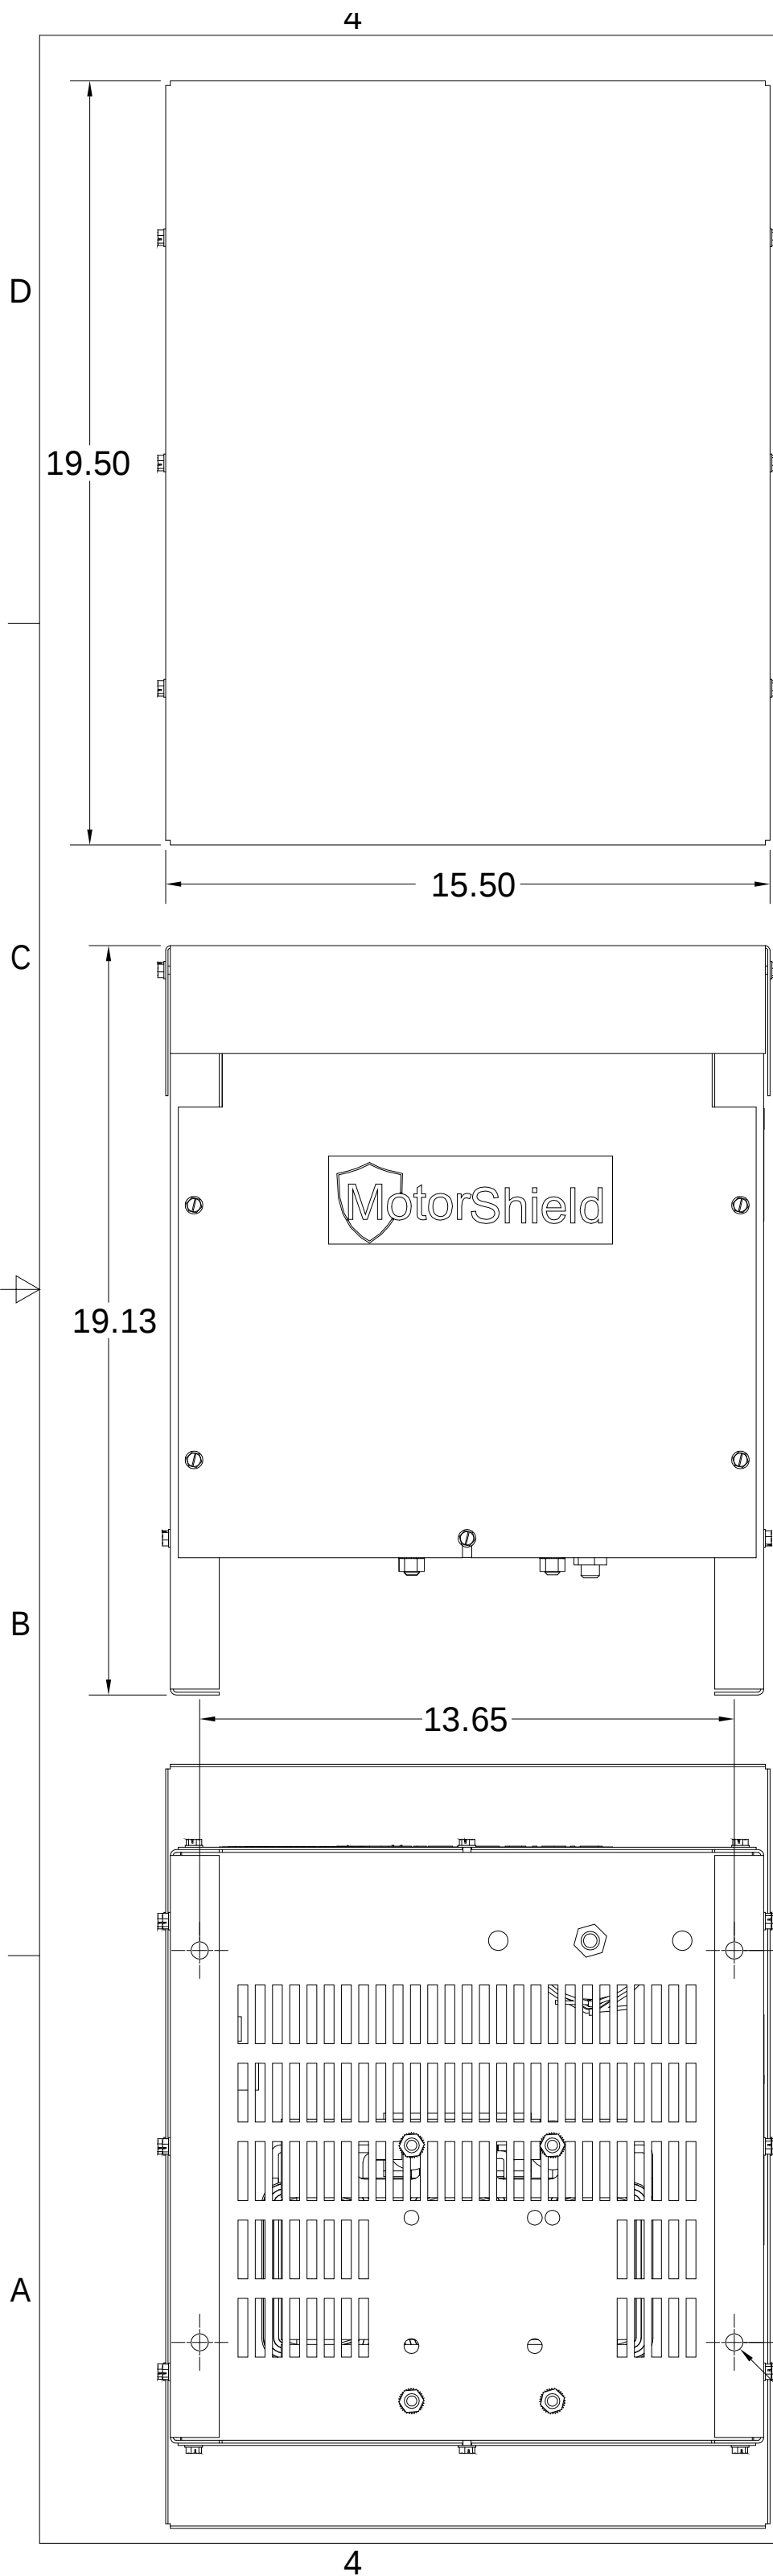


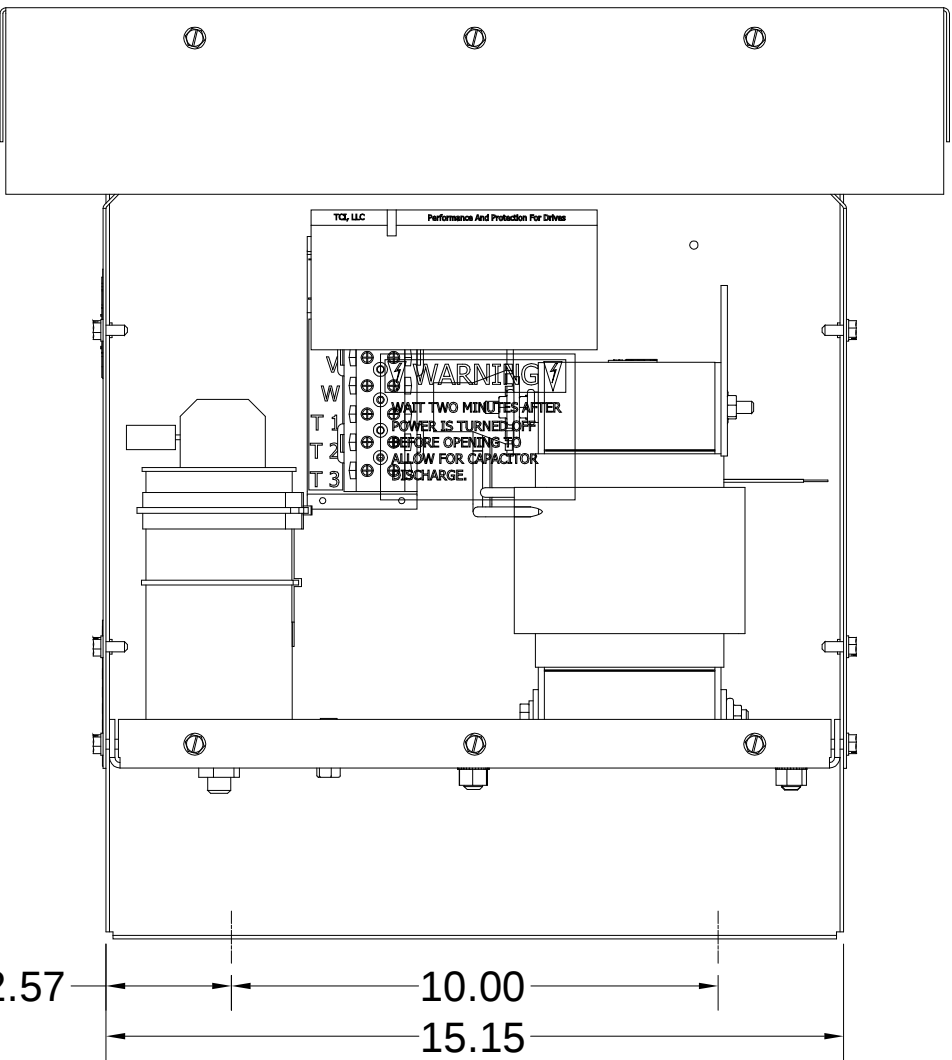

CUSTOMER CONNECTIONS

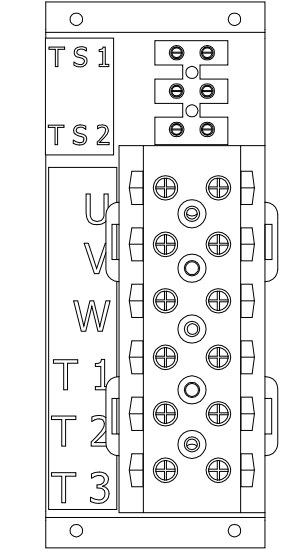

NOTE: FOR WIRE RANGE AND TORQUE INFORMATION SEE IOM MANUAL.

MSD PART NUMBER	HP	VOLTAGE	CURRENT	WEIGHT	TERMINAL BLOCK	GROUND LUG
MSD0055A300	40	480V	55 AMPS	105LBS	WIRE RANGE: 1-22AWG	WIRE RANGE: 2/0-14AWG

CUSTOMER IS RESPONSIBLE FOR INSTALLATION TO MEET ALL NATIONAL AND LOCAL ELECTRICAL CODES.

F	3696 ADD DISCHARGE LABEL	7/29/16	DSW	TOLERANCES (EXCEPT AS NOTED)	 TCI [®] W132 N10611 Grant Drive Germantown, WI 53022
E	3345 ENCLOSURE UPDATED	9/4/2015	DSW	DECIMAL	
D	3364, 75°C TO 90°C MIN	6/30/2015	DSW	.XX +/- .25	
C	3308 ADD CUSTOMER ENTRANCE	5/19/15	DSW	.XXX +/- .1	
B	3302 CAPS MOVED TO FRONT	5/6/2015	DSW	FRACTIONAL +/- 1/16	
A	AS BUILT	12/11/14	DSW	ANGULAR +/- 1°	DRN. BY DSW SCALE 1/4
NO	REVISION	DATE	BY		DATE 12/11/14 APRVD.
					DWG. No. 105796DG SHEET 1 OF 1